



1:100 C1 A-202 PARTIAL ELEVATION 4

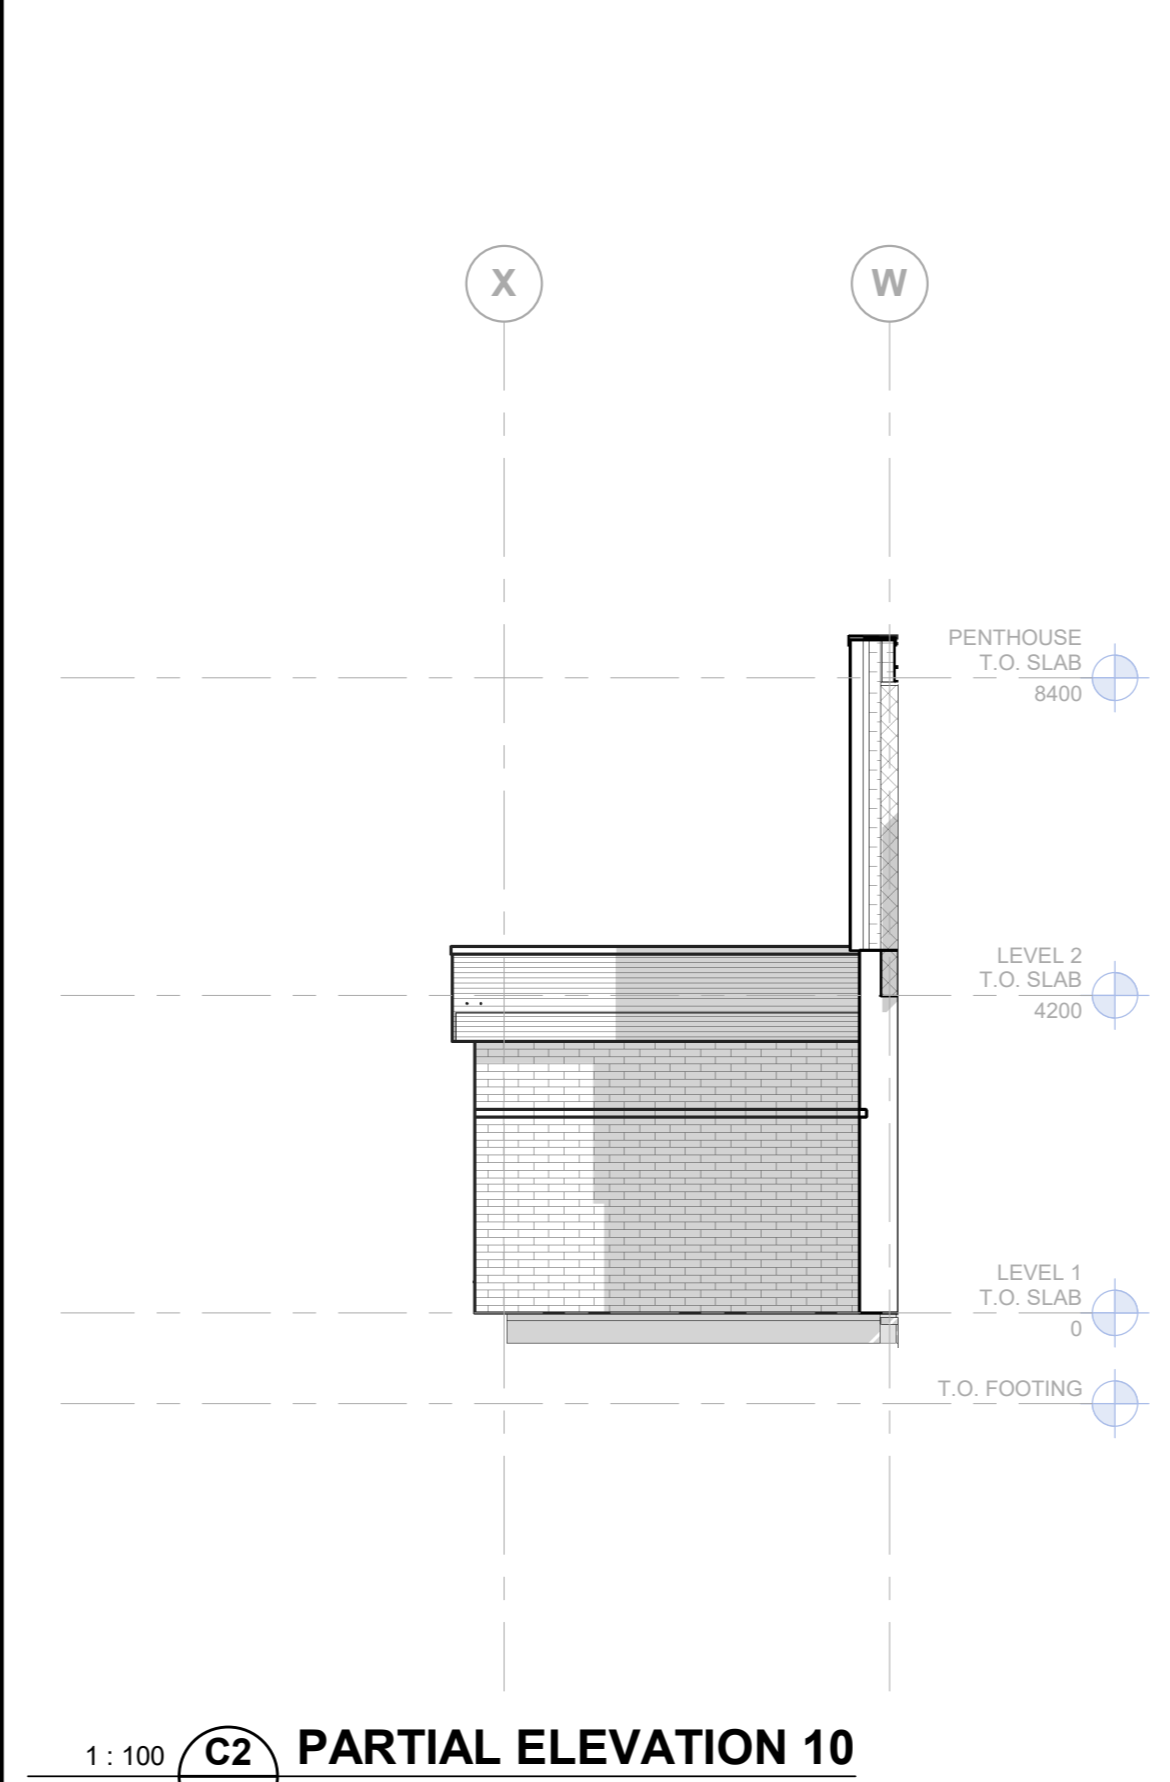


1:100 C2 A-202 PARTIAL ELEVATION 10

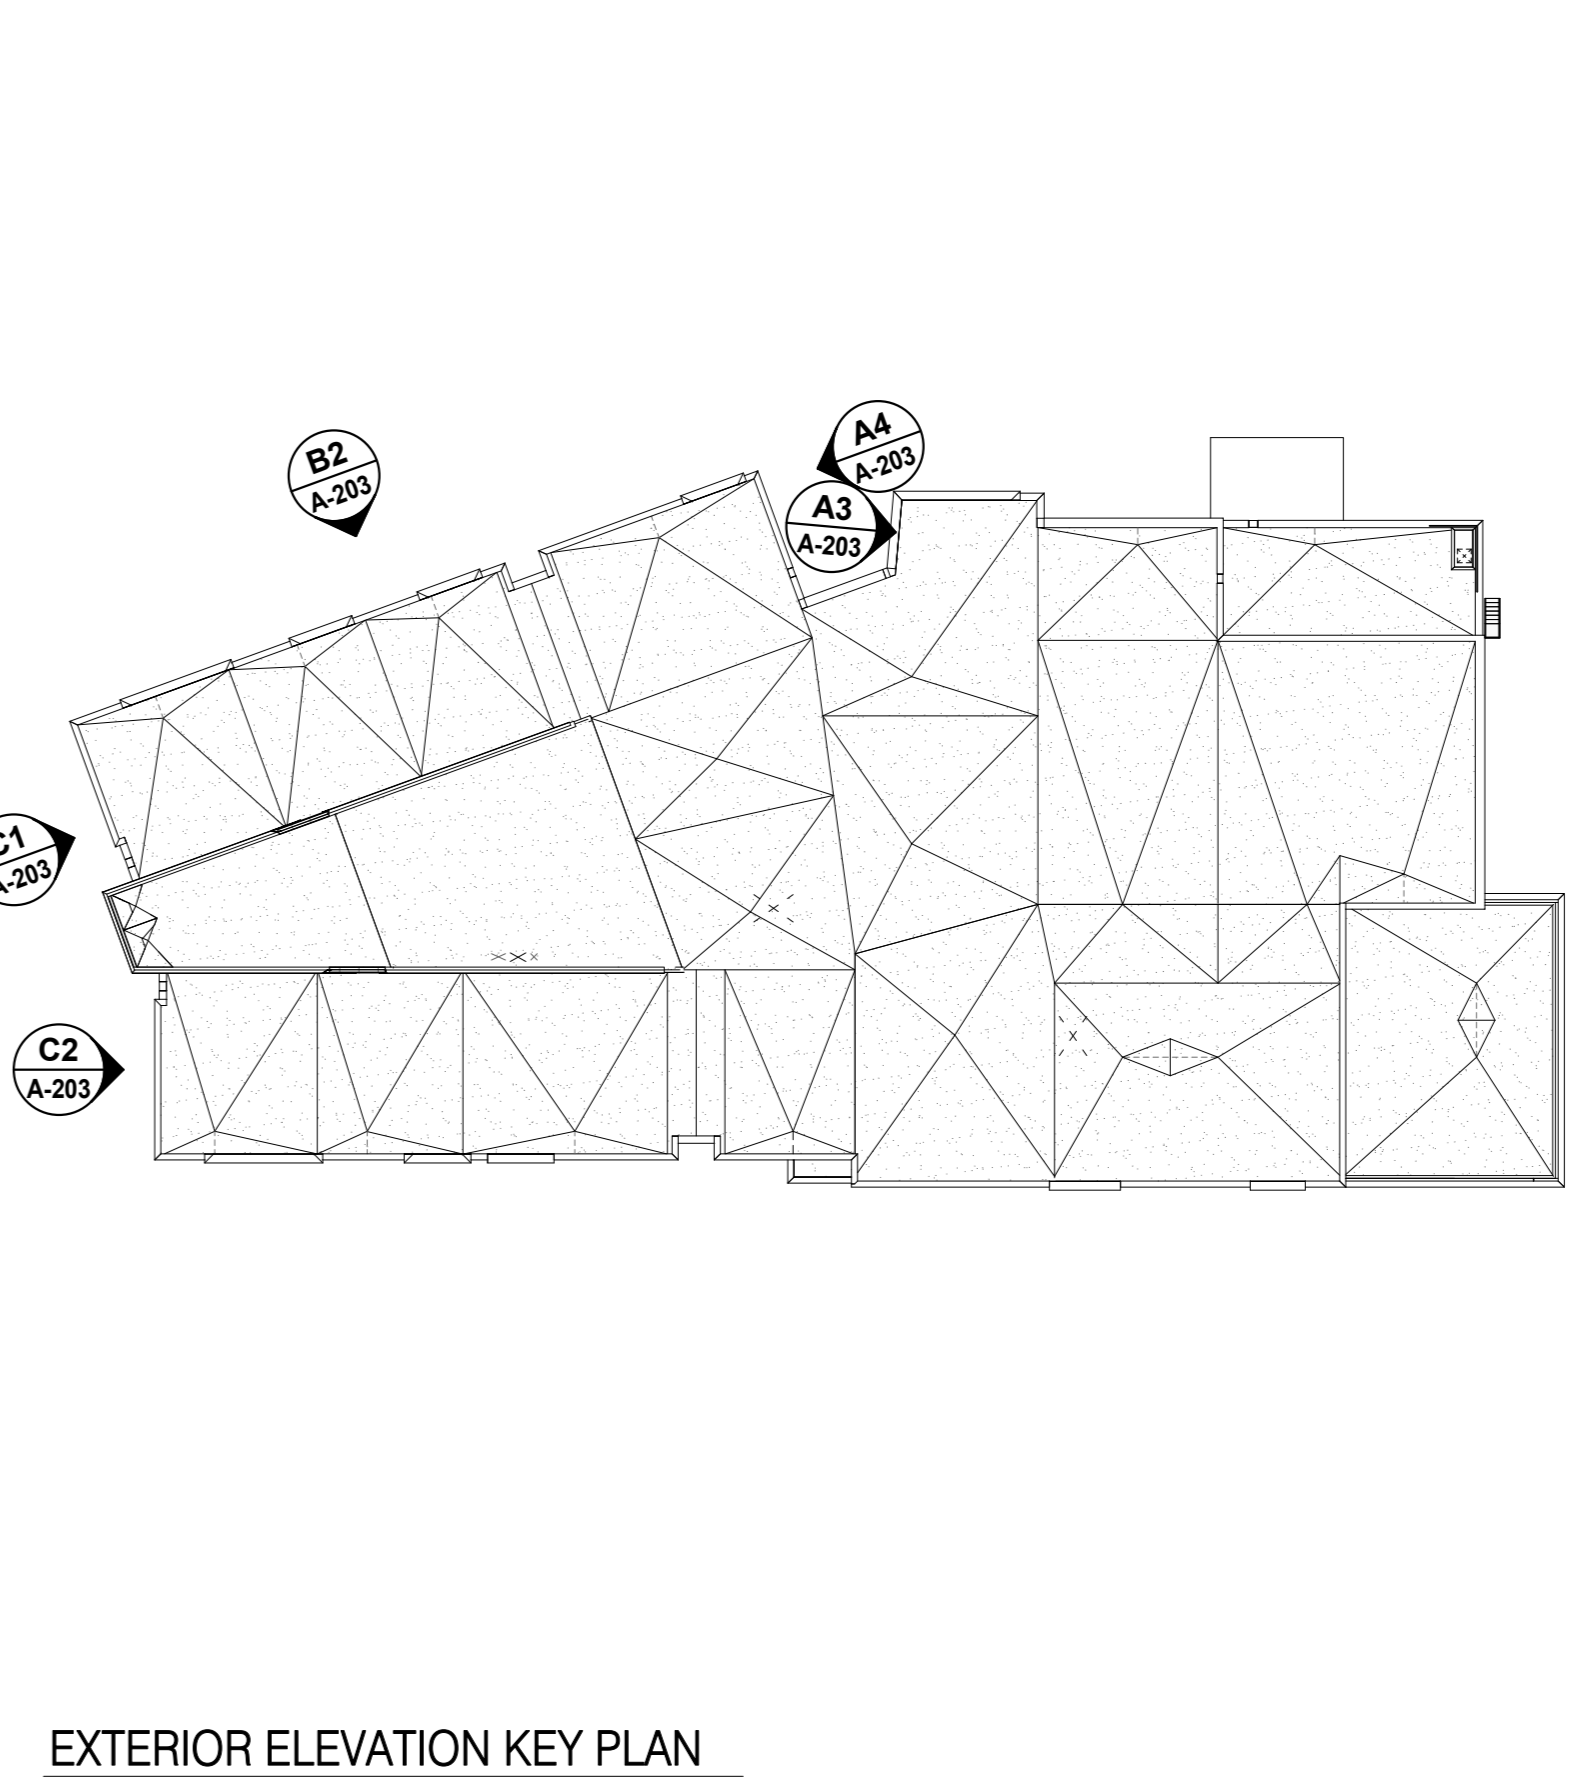


EXTERIOR ELEVATION KEY PLAN


MATERIAL LEGEND		NOTES LEGEND	
1	ARCHITECTURAL CONCRETE MASONRY VENEER	LL	LOOSE LINTEL, REFER TO STRUCTURAL
2.1	PRE-FINISHED HORIZONTAL METAL SIDING - CORRUGATED, COLOR 1	PJ	PANEL JOINT
2.2	PRE-FINISHED HORIZONTAL METAL SIDING - CORRUGATED, COLOR 2	CJ	CONTROL JOINT
2.3	PRE-FINISHED HORIZONTAL METAL SIDING - CORRUGATED, COLOR 3		
3.1	PRE-FINISHED METAL SIDING, COLOR 1 (BLUE)		
3.2	PRE-FINISHED METAL SIDING, COLOR 2 (YELLOW)		
3.3	PRE-FINISHED METAL SIDING, COLOR 3 (WHITE)		
4.1	PRE-FINISHED METAL CAP FLASHING - COLOUR TO MATCH MASONRY VENEER		
4.2	PRE-FINISHED METAL CAP FLASHING - COLOUR TO MATCH CORRUGATED METAL SIDING, COLOR 1		
4.3	PRE-FINISHED METAL CAP FLASHING - CORRUGATED METAL SIDING		
4.4	PRE-FINISHED METAL CAP FLASHING - COLOUR TO MATCH METAL SIDING, COLOR 1 (BLUE)		
4.5	PRE-FINISHED METAL CAP FLASHING - COLOUR TO MATCH METAL SIDING, COLOR 2 (YELLOW)		
4.6	PRE-FINISHED METAL CAP FLASHING - COLOUR TO MATCH CORRUGATED METAL SIDING, COLOR 3 (WHITE)		
5.1	PRE-FINISHED METAL FLASHING - COLOUR TO MATCH MASONRY VENEER		
5.2	PRE-FINISHED METAL FLASHING - COLOUR TO MATCH CORRUGATED METAL SIDING, COLOR 1		
5.3	PRE-FINISHED METAL FLASHING - COLOUR TO MATCH CORRUGATED METAL SIDING, COLOR 1		
5.4	PRE-FINISHED METAL FLASHING - COLOUR TO MATCH METAL SIDING, COLOR 1 (BLUE)		
6.1	SCUPPER DRAIN - FLASHING COLOUR TO MATCH MASONRY VENEER		
6.2	SCUPPER DRAIN - FLASHING COLOUR TO MATCH CORRUGATED METAL SIDING		
6.3	SCUPPER DRAIN - FLASHING COLOUR TO MATCH METAL SIDING, COLOR 1 (BLUE)		
7.1	INSULATED METAL DOOR & FRAME - PAINTED TO MATCH MASONRY VENEER		
7.2	INSULATED METAL DOOR & FRAME - PAINTED TO MATCH METAL SIDING, PENTHOUSE		
8.1	PRE-FINISHED LOUVRE - REFER TO MECHANICAL		
8.2	PRE-FINISHED STORM LOUVRE - REFER TO MECHANICAL		

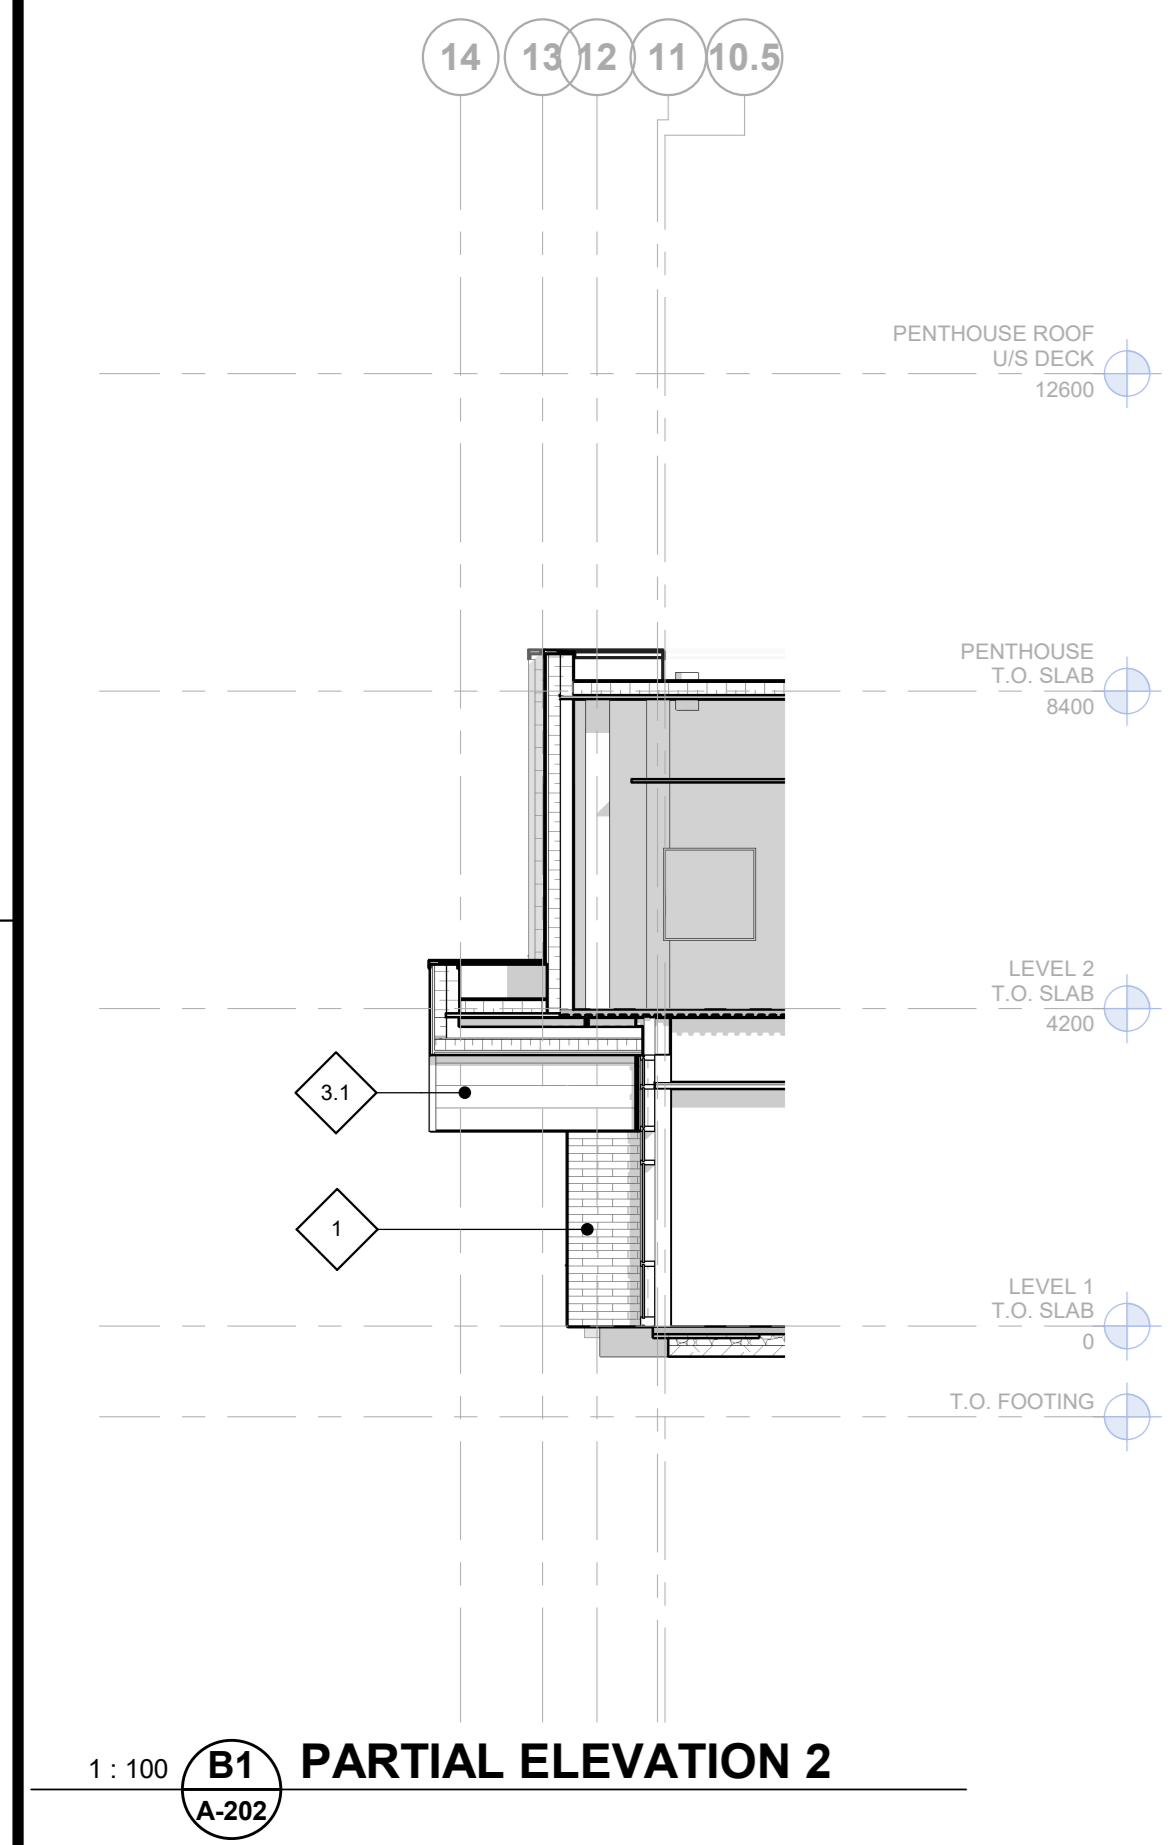

1:100 B1 A-202 PARTIAL ELEVATION 2

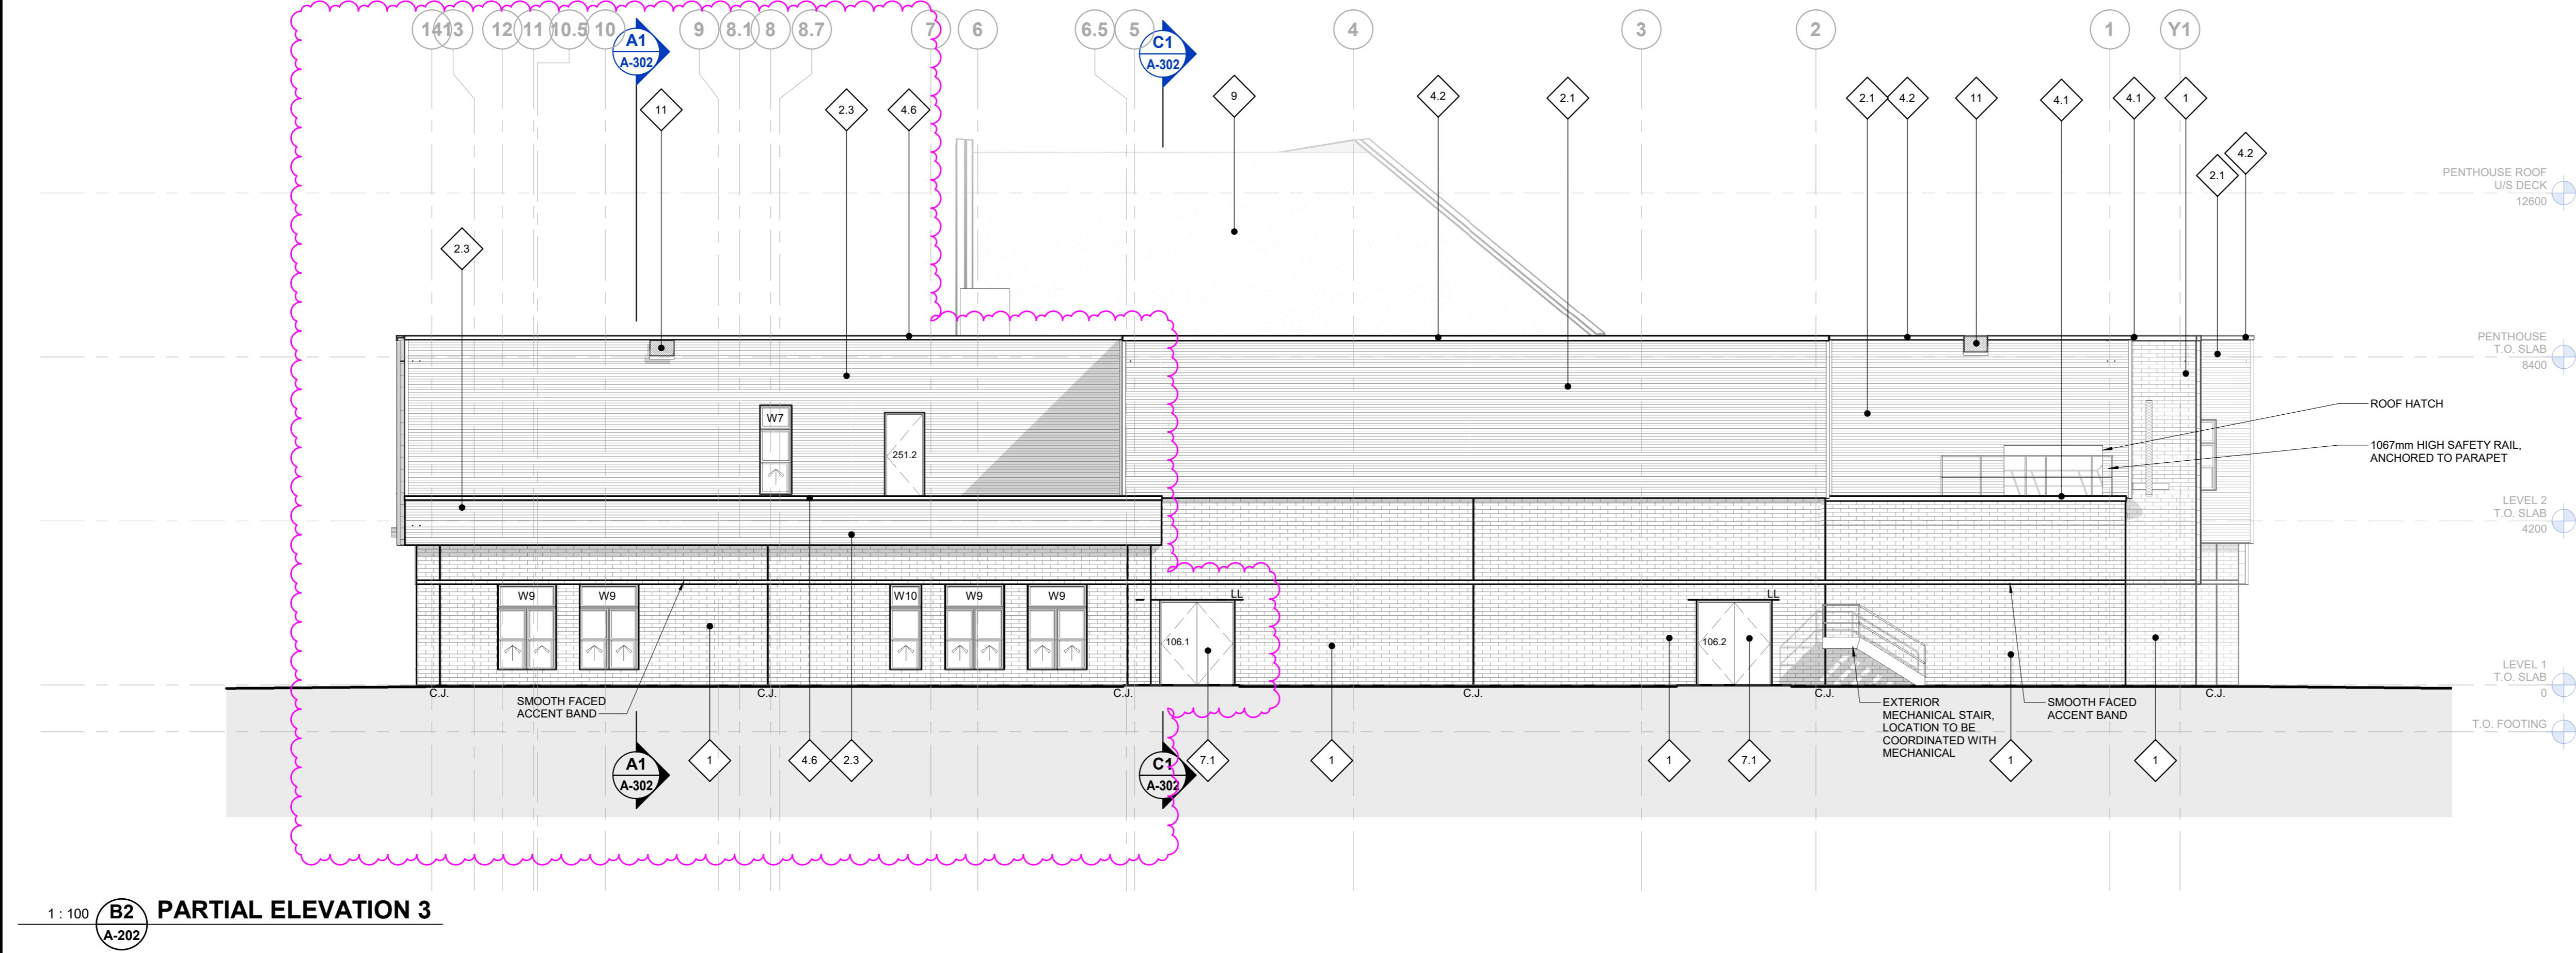

1:100 B2 A-202 PARTIAL ELEVATION 3

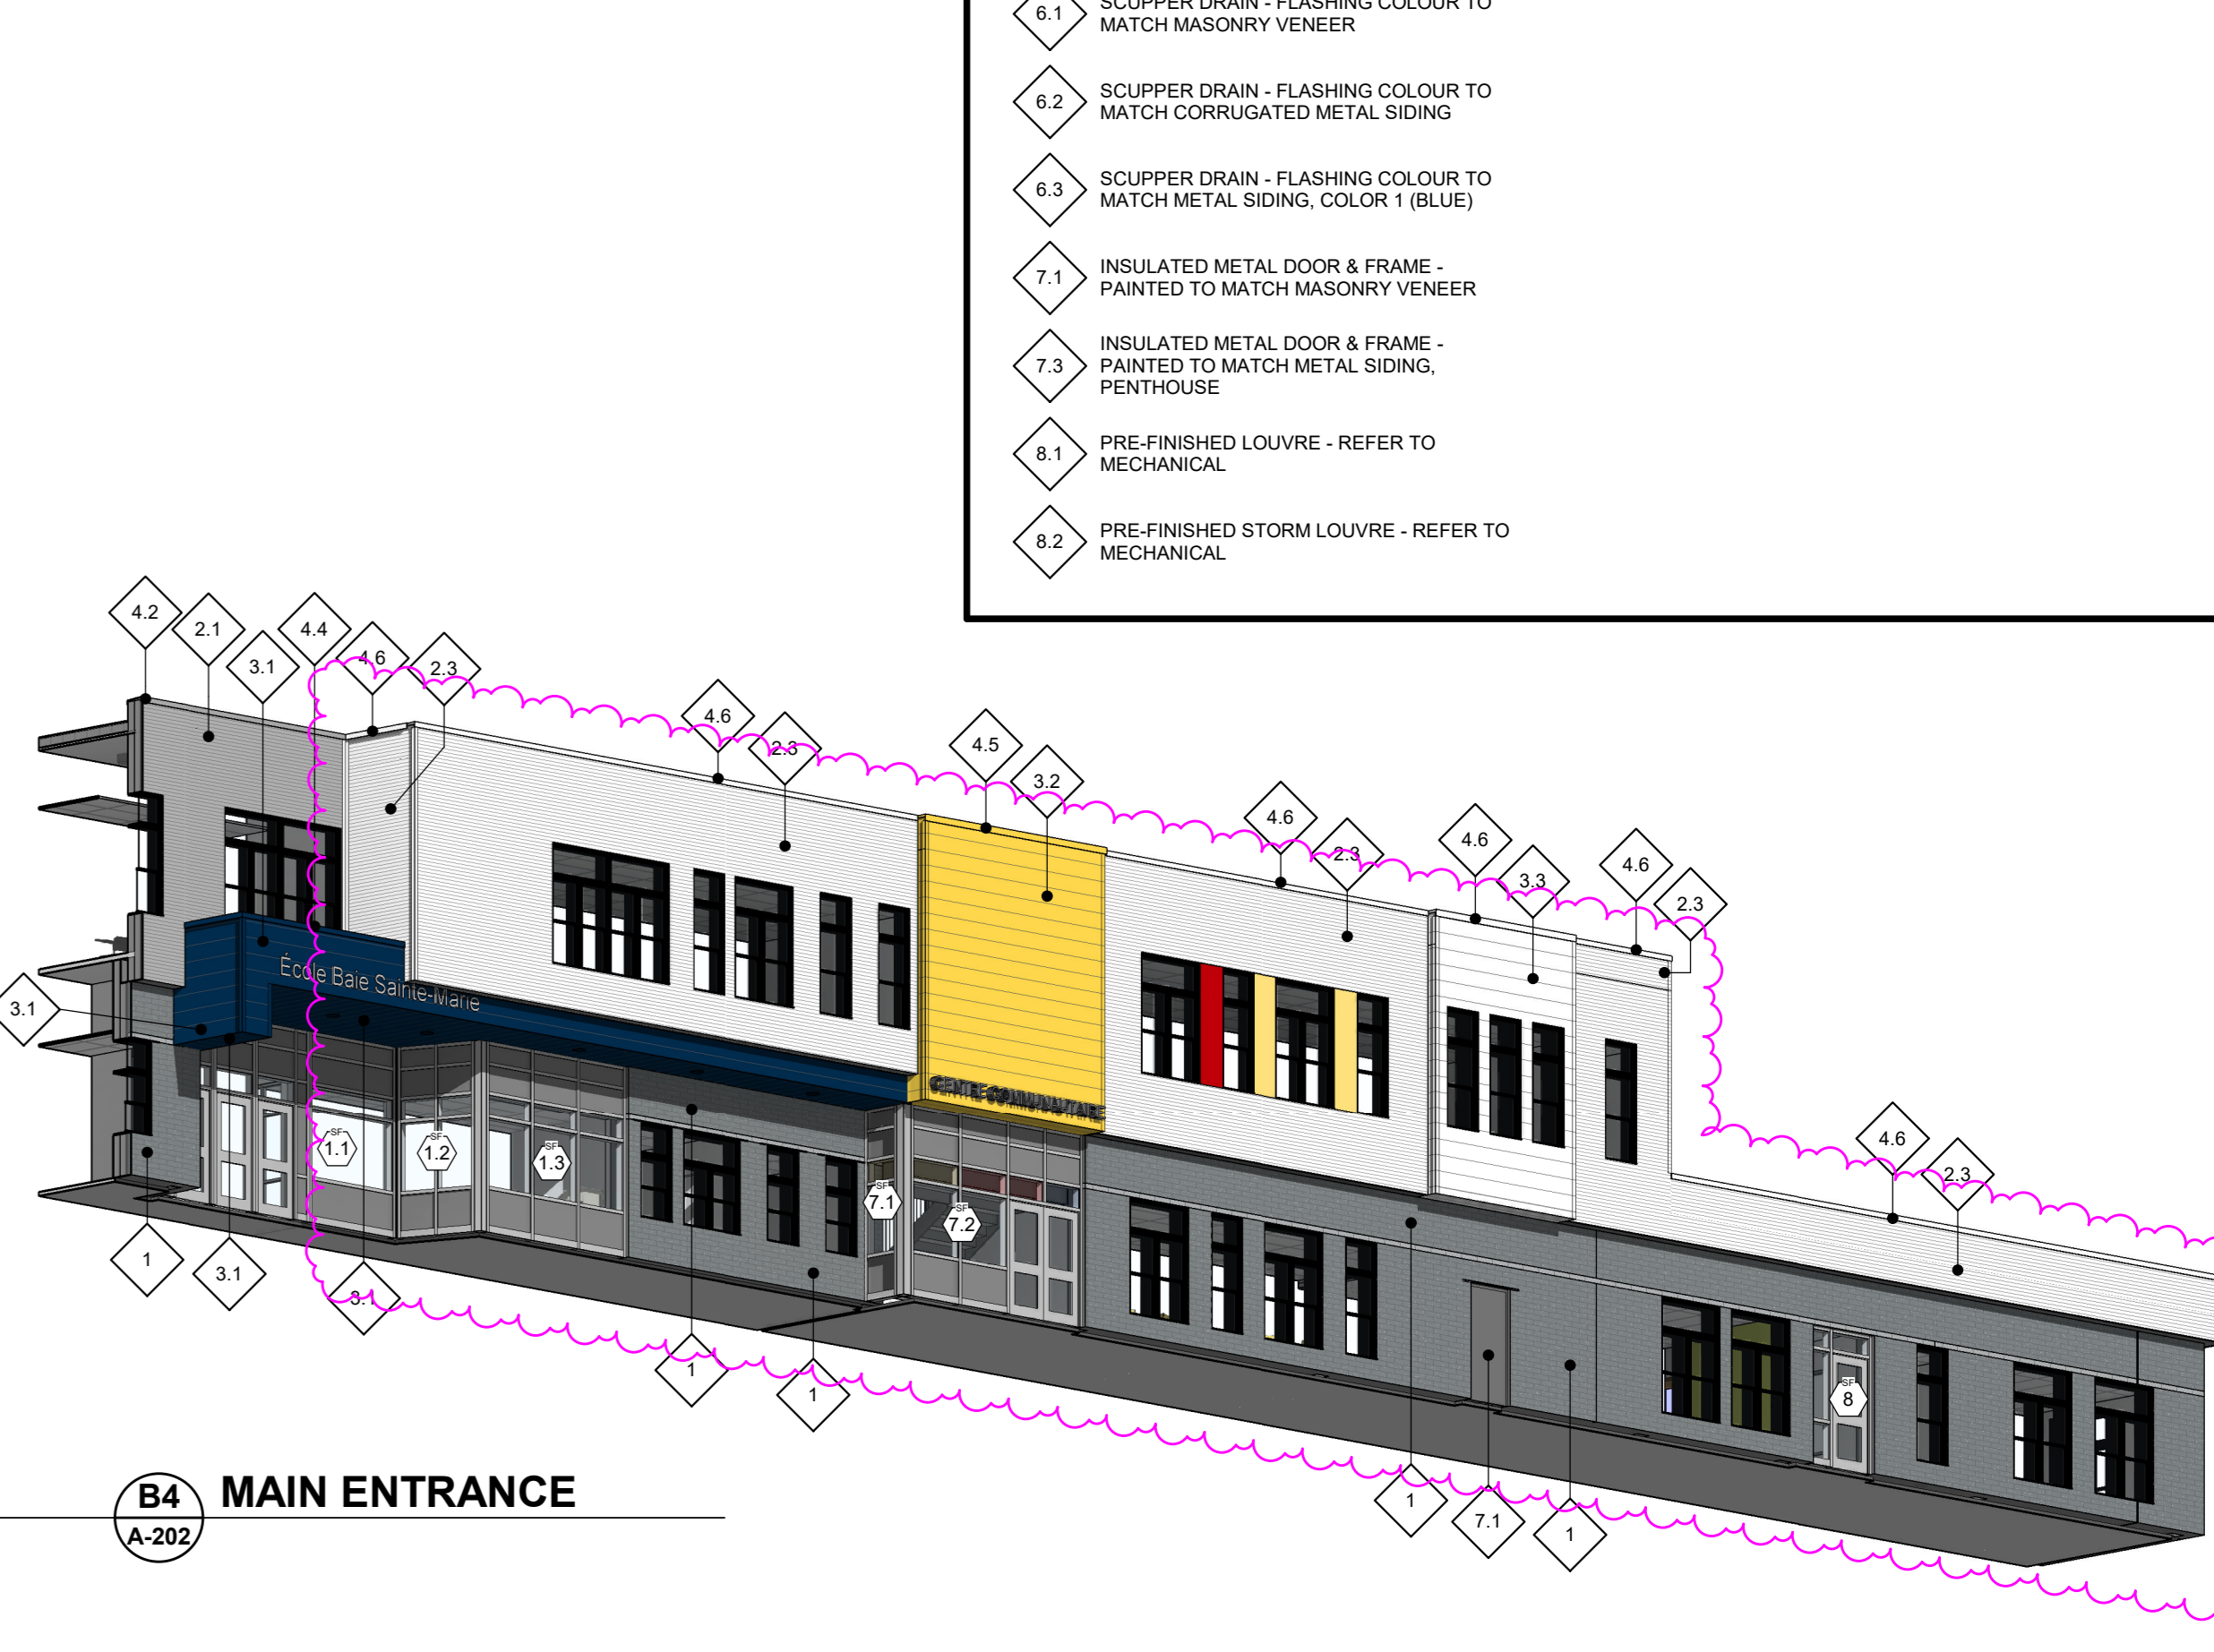

B4 A-202 MAIN ENTRANCE



1:100 A1 A-202 PARTIAL ELEVATION 1

		ARCHITECT: ARCHITECTURE 49 1640 Market Street, Halifax, Nova Scotia, Canada, B3J 2C8 T: 902.429.5490 F: 902.429.2632 www.architecture49.com	GRAPHIC SCALE: 0m 1 2 3 4 5 NORTH ARROW:	DISCLAIMER: THIS DRAWING AND DESIGN IS COPYRIGHT PROTECTED WHICH SHALL NOT BE USED, REPRODUCED OR REVISED WITHOUT WRITTEN PERMISSION BY ARCHITECTURE 49 INC. THE CONTRACTOR SHALL CHECK AND VERIFY ALL DIMENSIONS AND REPORT ALL ERRORS AND OMISSIONS PRIOR TO COMMENCING WORK. THIS DRAWING IS NOT TO BE SCALED.	PROJECT: PP-6 CONSEIL SCOLAIRE ACADIEN CLARE TP3 - MAIN BUILDING LOWER SAULNIERVILLE, NOVA SCOTIA SCALE: As indicated DRAWN BY: S. Porter & I. Miller CHECKED BY: J. Dotten REVIEWED BY: C. Heffer APPROVED BY: S. Hughes AS-BUILT CHECK: DATE: NOVEMBER 29, 2022	PROJECT NO.: L03-04-01-01 SHEET TITLE: PARTIAL EXTERIOR ELEVATIONS INTERNAL NO.: 209-00111-00 DWG NO.: A-202 SHEET 21 OF 48														
		KEY PLAN:	ARCHITECTURE 49	ISSUE / REVISION SCHEDULE: <table border="1"> <thead> <tr> <th>DATE</th> <th>MARK</th> <th>ISSUE</th> </tr> </thead> <tbody> <tr> <td>AUG 30/23</td> <td>4</td> <td>CO-REV (COMM CENTRE) ADDITION</td> </tr> <tr> <td>AUG 10/23</td> <td>2</td> <td>ISSUED FOR CONMO1</td> </tr> <tr> <td>MAR 15/23</td> <td>1</td> <td>ISSUED FOR CONSTRUCTION</td> </tr> <tr> <td>NOV 28/22</td> <td>0</td> <td>ISSUED FOR TENDER</td> </tr> </tbody> </table>	DATE	MARK	ISSUE	AUG 30/23	4	CO-REV (COMM CENTRE) ADDITION	AUG 10/23	2	ISSUED FOR CONMO1	MAR 15/23	1	ISSUED FOR CONSTRUCTION	NOV 28/22	0	ISSUED FOR TENDER	STAMP: FOR INFORMATION ONLY
DATE	MARK	ISSUE																		
AUG 30/23	4	CO-REV (COMM CENTRE) ADDITION																		
AUG 10/23	2	ISSUED FOR CONMO1																		
MAR 15/23	1	ISSUED FOR CONSTRUCTION																		
NOV 28/22	0	ISSUED FOR TENDER																		